


# Cave Run Lake Fish Attractor Map

This map is not for sale or for use with any other advertising

Revised: August 2017

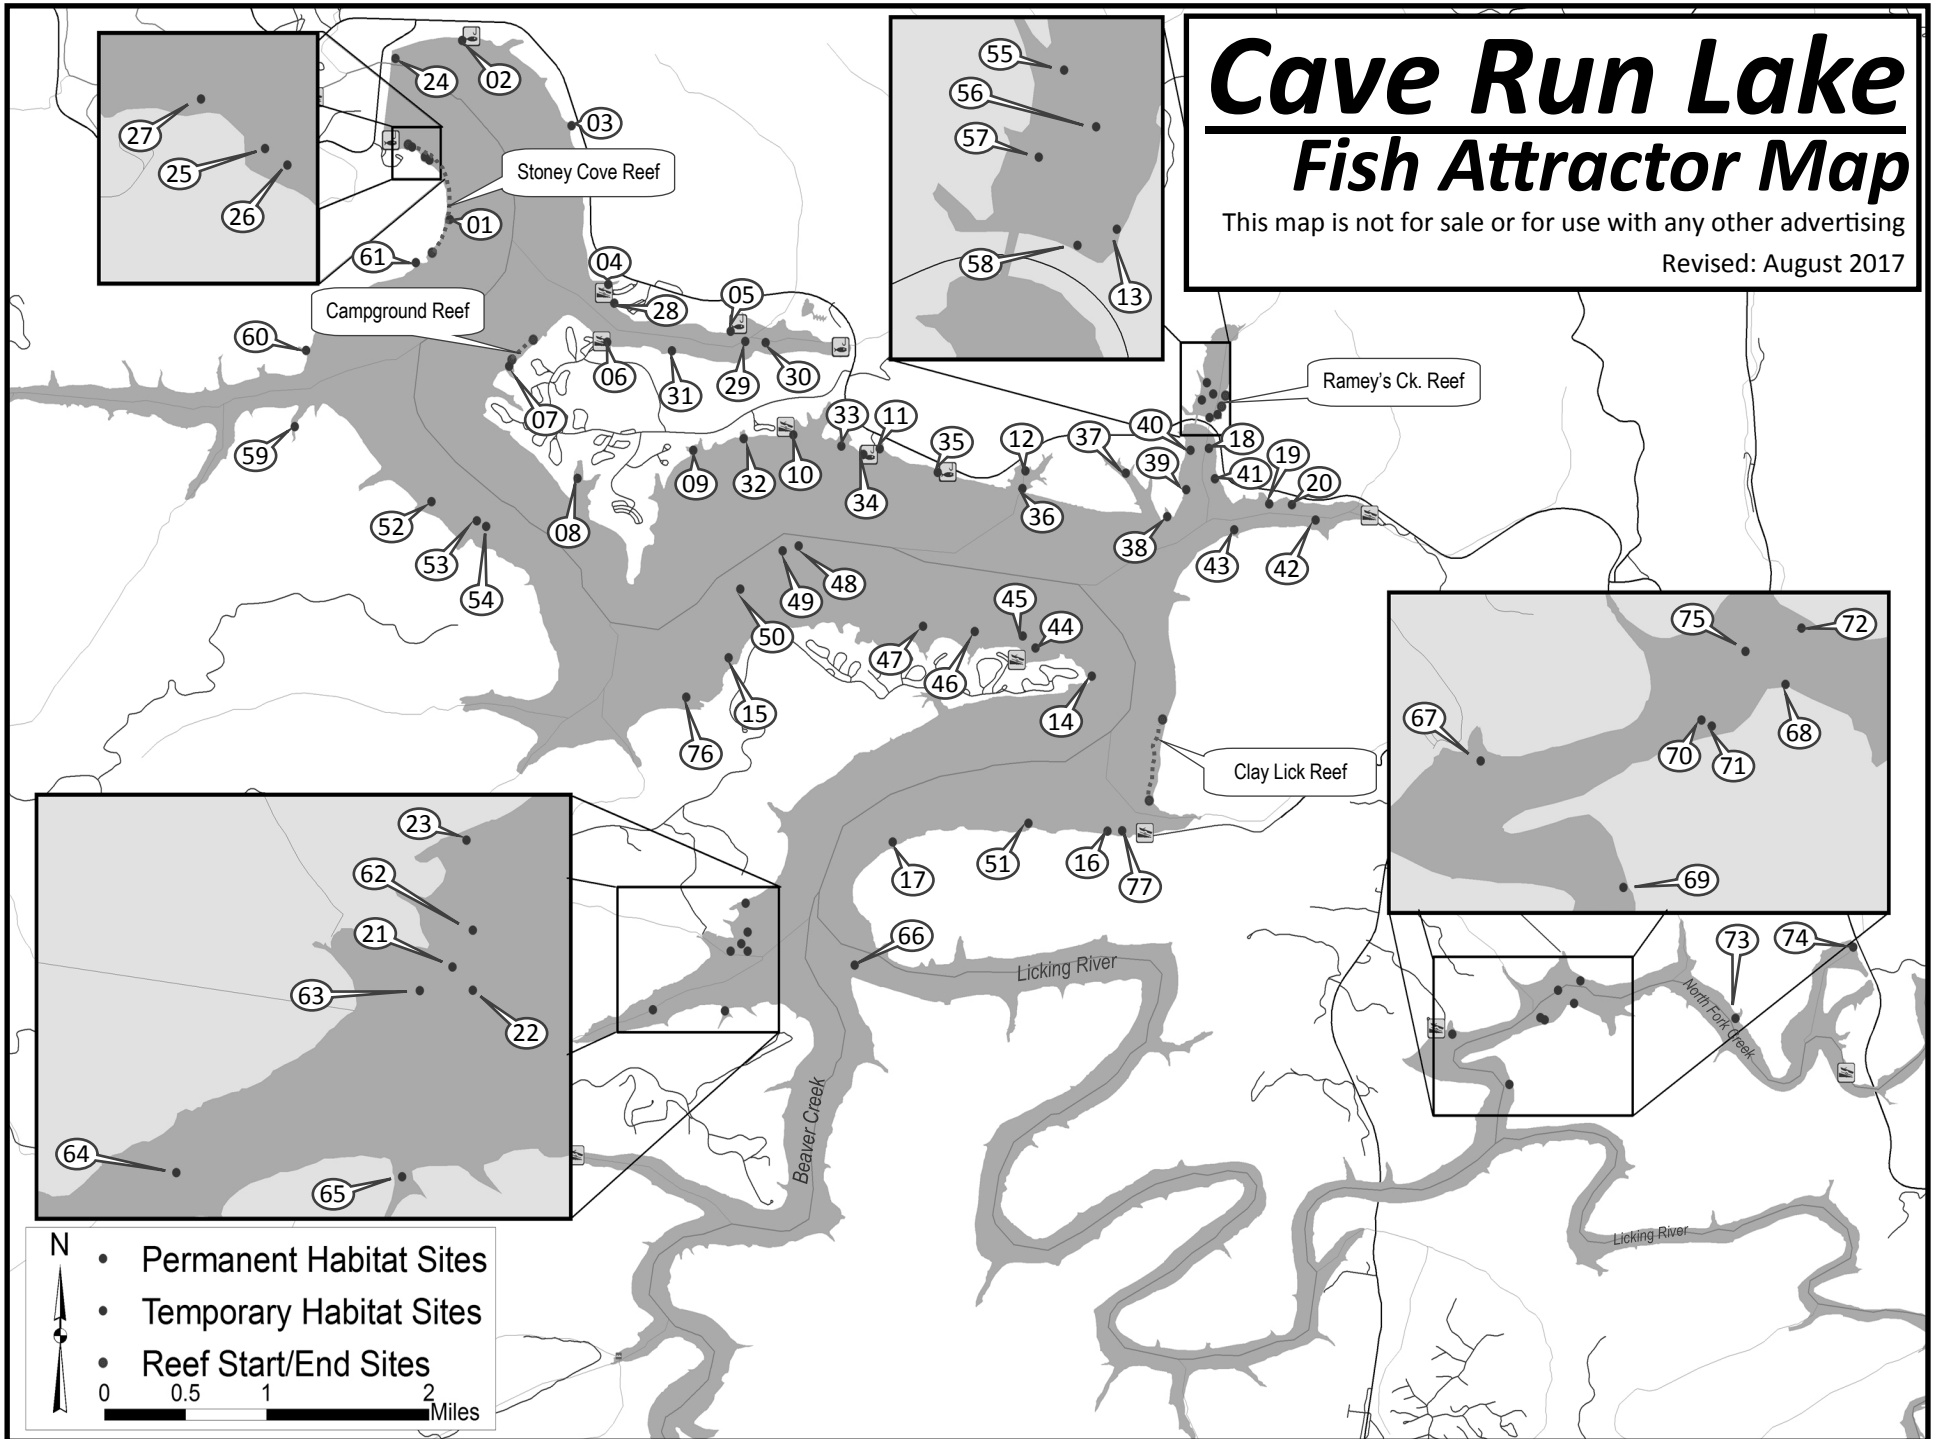

N

- Permanent Habitat Sites
- Temporary Habitat Sites
- Reef Start/End Sites

0 0.5 1 2 Miles

# Cave Run Lake Fish Attractor Map

## How To Use This Map...

This map is designed to increase your odds of finding department placed habitat sites. GPS coordinates are provided to assist with this (see the tables on the right). Coordinates will get you in the vicinity of the site, but depending on your model of GPS, the weather and cloud cover you may not be put directly on top of the habitat site. In addition to the GPS locations the type of material and the date of refresh are also provided.

The 4 habitat reefs on the lake are a collection of all habitat types. The GPS coordinates for the starting and ending points on these reefs are provided as well as the depth (at summer pool) of these reefs. These reefs have hundreds of structures within these depths and GPS points.

## What To Do If These Coordinates "Don't Work"...

The GPS coordinates provided are accurate. The maps on the front are created by using the GPS coordinates that are provided at the right. If your GPS is showing these locations off the lake, you most likely are not entering the coordinates in the correct format. In order to correct this you need to change the format of your GPS point entry to "decimal degrees" (or D.d).

There are many formats used in GPS. There are many online converters available and GPS points in 3 of the most common formats provided on our website: fw.ky.gov (search Cave Run Habitat at the top).

## About the Fish Attractor Program...

Kentucky Fish and Wildlife, the US Forest Service and the US Army Corps of Engineers have cooperated on adding fish habitat to Cave Run Lake since the early 1980's. In 2013 a larger scale habitat project was implemented on the lake taking the number of habitat sites from 16 to almost 80 along with 4 reefs. These larger sites are made up of a mixture of pallets, concrete structures, larger cedar trees, stumps, stake buckets and much more. This project is a continuous project with efforts shifting toward maintenance of existing sites starting in 2018.

How can you help? Let us know your favorite (or least favorite) spots... as we move forward with this project sites that are not successful will be dropped to make it easier to maintain the successful sites and search for new locations. Additionally, we are also always looking for environmentally safe material in large quantities to use as fish habitat.

Have questions? Have material? Talk to us...

Email: tom.timmermann@ky.gov or call: 606-783-8650.



US ARMY  
CORPS OF ENGINEERS

Permeant Habitat Locations						Temporary Habitat Locations					
SITE	NAME	NORTHING	WESTING	LAST DATE	TYPE	SITE	NAME	NORTHING	WESTING	LAST DATE	TYPE
1	Dead Tree	38.10789	-83.52680	2014	Mixed Small	28*	Marina	38.10125	-83.51215	2015	Mixed Small
2*	High Bank	38.12208	-83.52569	2014	Trees Small	29	Scott's Creek B	38.09822	-83.50044	2015	Mixed Large
3	801 Cut	38.11532	-83.51595	2015	PVC	30	Scott's Creek C	38.09812	-83.49862	2015	Trees Large
4*	Billy Branch	38.10275	-83.51267	2015	Trees Small	31	Scott's Creek A	38.09747	-83.507	2015	Mixed Large
5	Boat Gunnel	38.09902	-83.50175	2011	PVC	32	Alfrey B	38.09053	-83.50059	2015	Mixed Large
6	Twin Knobs Ramp	38.09815	-83.51277	2015	Mixed Small	33	Alfrey C	38.08993	-83.49188	2015	Mixed Large
7*	I-Loop	38.09625	-83.52152	2015	Plastic/Trees	34*	Muskie Bend B	38.08926	-83.48992	2015	Wood Pallets
8*	Sewer Plant	38.08737	-83.51540	2013	Trees Small	35*	Lakeview Vista	38.08785	-83.48327	2015	Mixed Large
9	Group Use	38.08960	-83.50510	2016	Trees Small	36	Cassidy Fork B	38.08655	-83.47574	2015	Stake Buckets
10	Alfrey-A	38.09082	-83.49617	2015	Trees Small	37	Shrout	38.08779	-83.46651	2016	Mixed Large
11*	Muskie Bend-A	38.08970	-83.48847	2015	Mixed Small	38	Spaulding Point	38.08432	-83.46283	2016	Stake Buckets
12	Caddisy Ford-A	38.08797	-83.47545	2013	Trees Small	39	Mays Landing	38.08648	-83.46113	2016	Plastic/Trees
13*	Ramey's Creek	38.09243	-83.45833	2015	Trees Small	40	Howes Hole	38.08961	-83.46075	2016	Mixed Large
14	Zilpo Point	38.07168	-83.46955	2013	Trees Small	41*	Windy Bay Rocks	38.08734	-83.45856	2016	Mixed Small
15	Flat's Pallets	38.07315	-83.50192	2015	Wood Pallets	42	Warix	38.08406	-83.44958	2016	Trees Large
16	Clay Lick Pallets	38.05940	-83.46813	2014	Wood Pallets	43	Warix Ditch	38.08329	-83.45685	2016	Mixed Large
17	Clay Lick	38.05853	-83.48730	2014	Mixed Small	44	Barrett Pile	38.07393	-83.47458	2016	Mixed Small
18	Hump	38.08975	-83.45909	2016	PVC	45	Zilpo Ramp	38.07487	-83.4757	2016	Mixed Small
19*	Atmos Cove	38.08533	-83.45373	2016	PVC	46	Zilpo Beach 1	38.07524	-83.47998	2016	Mixed Large
20	Warix Culvert	38.08527	-83.45168	2016	PVC	47	Zilpo Beach 2	38.07566	-83.48458	2016	Mixed Large
21	Short Mossback	38.05047	-83.50082	2017	PVC	48	Columnaris	38.08201	-83.4957	2016	Mixed Large
22	Tall Mossback	38.04988	-83.50023	2017	PVC	49	Johnson	38.08163	-83.49711	2016	Mixed Large
23	Pomoxis Flats	38.05369	-83.50042	2017	PVC	50	Micropterus	38.07859	-83.5009	2016	Mixed Large
24	Dam Stumps	38.12065	-83.53165	2017	Large Stumps	51	Pine Tree	38.06002	-83.47518	2016	Mixed Small
25	Sheltowee 1	38.11285	-83.52903	2017	Large Stumps	52	Tr 106	38.08552	-83.52845	2017	Mixed Small
26	Sheltowee 2	38.11258	-83.52863	2017	Large Stumps	53	Point Claire	38.084	-83.5244	2017	Mixed Small
27	Hog Hollow	38.11363	-83.53017	2017	Large Stumps	54	Hog Pen	38.08355	-83.52355	2017	Mixed Small
75	North Fork	38.0468	-83.42795	2017	Plastics	55	Big Hollow	38.09495	-83.45927	2017	Mixed Small
76	Red's Point	38.07003	-83.50572	2017	FisHiding	56	Middle	38.09405	-83.4587	2017	Mixed Small
77	Rock Pile	38.05943	-83.46683	2017	Rock Pile	57	Gadwall Cove	38.09357	-83.45972	2017	Mixed Small
						58	Dam Corner	38.09217	-83.45903	2017	Mixed Small
						59*	Caney Loop	38.09148	-83.54063	2017	Stake Buckets
						60	Aythya Bend	38.0975	-83.53962	2017	Stake Buckets
						61	Graveyard	38.10448	-83.52985	2017	Stake Buckets
						62	Cassidys	38.0514	-83.50024	2017	Mixed Large
						63	McIntosh	38.04987	-83.50175	2017	Mixed Large
						64	Buck Creek	38.04525	-83.5087	2017	Mixed Large
						65	Aixsonsa Cove	38.04515	-83.50225	2017	Mixed Large
						66	Mouth Licking	38.0488	-83.4907	2017	Mixed Large
						67	Bangor Ramp	38.043317	-83.4374	2017	Trees Large
						68	River's Edge	38.04575	-83.42652	2017	Mixed Large
						69	Nickell's Mounds	38.039317	-83.4323	2017	Mixed Large
						70	Fence Row 2	38.044617	-83.42952	2017	Mixed Large
						71	Fence Row 1	38.044433	-83.42915	2017	Mixed Large
						72	Hef's Landing	38.047533	-83.42595	2017	Mixed Large
						73	Flagpole	38.04455	-83.41213	2017	Mixed Large
						74*	519 Culvert	38.0502	-83.40163	2017	Mixed Large

\* Site can be fished from the bank

Habitat Reef Locations				
Attractor	Depth <sup>a</sup> (feet)	NORTHING	WESTING	LAST DATE
Stoney Cove Reef Start	10-20	38.10523	-83.5284	2014
Stoney Cove Reef End		38.1138	-83.5305	
Clay Lick Reef Start	10-20	38.06182	-83.4644	2014
Clay Lick Reef End		38.06825	-83.4633	
Campground Reef Start*	14-20	38.09677	-83.5213	2015
Campground Reef End*		38.09835	-83.5194	
Ramey's Ck. Reef Start*	05-10	38.09306	-83.458	2017
Ramey's Ck. Reef End*		38.09392	-83.4576	

\* Site can be fished from the bank  
<sup>a</sup> Depths are at summer pool levels

\* Site can be fished from the bank